


# HULL 061 HSV 2 SWIFT 98M

\*GA is 'as built' on delivery 2003

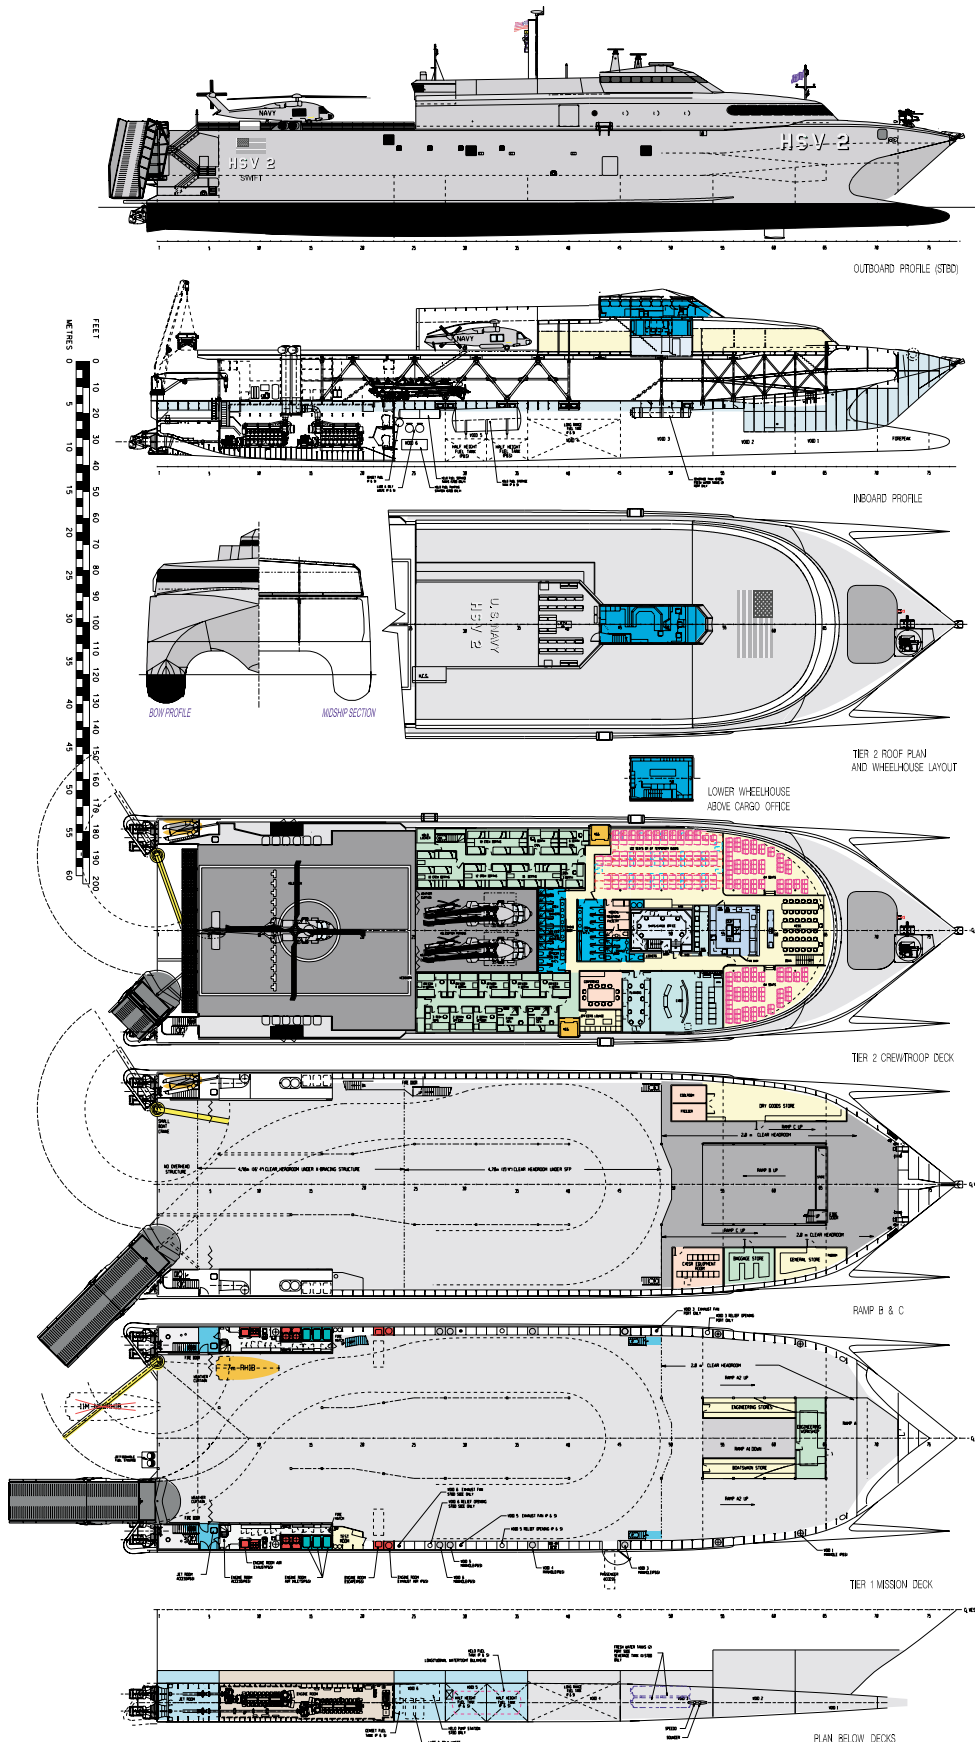

## GENERAL PARTICULARS

- Designer/Builder: Incat, Hobart, Australia
- Class Society: Det Norske Veritas
- Certification: DNV +1A1 R1 HSLC Cargo EO HELDK
- Length overall: 97.22 metres (318'11")
- Length waterline: 92.00 metres (301'9")
- Beam overall: 26.60 metres (87'3")
- Beam of Hulls: 4.50 metres (14' 8")
- Draft: 3.43 metres (11'3") loaded
- Speed: approx 38.0 knots @ 627 tonnes deadweight  
approx 42.0 knots @ 300 tonnes deadweight